



DRAWINGS BY:

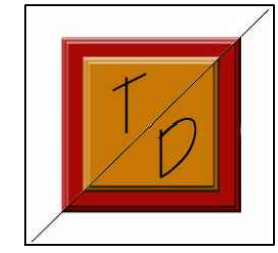

TRUE DIMENSIONS
ASPEN@TRUEDIMENSIONS.COM
970.618.8551

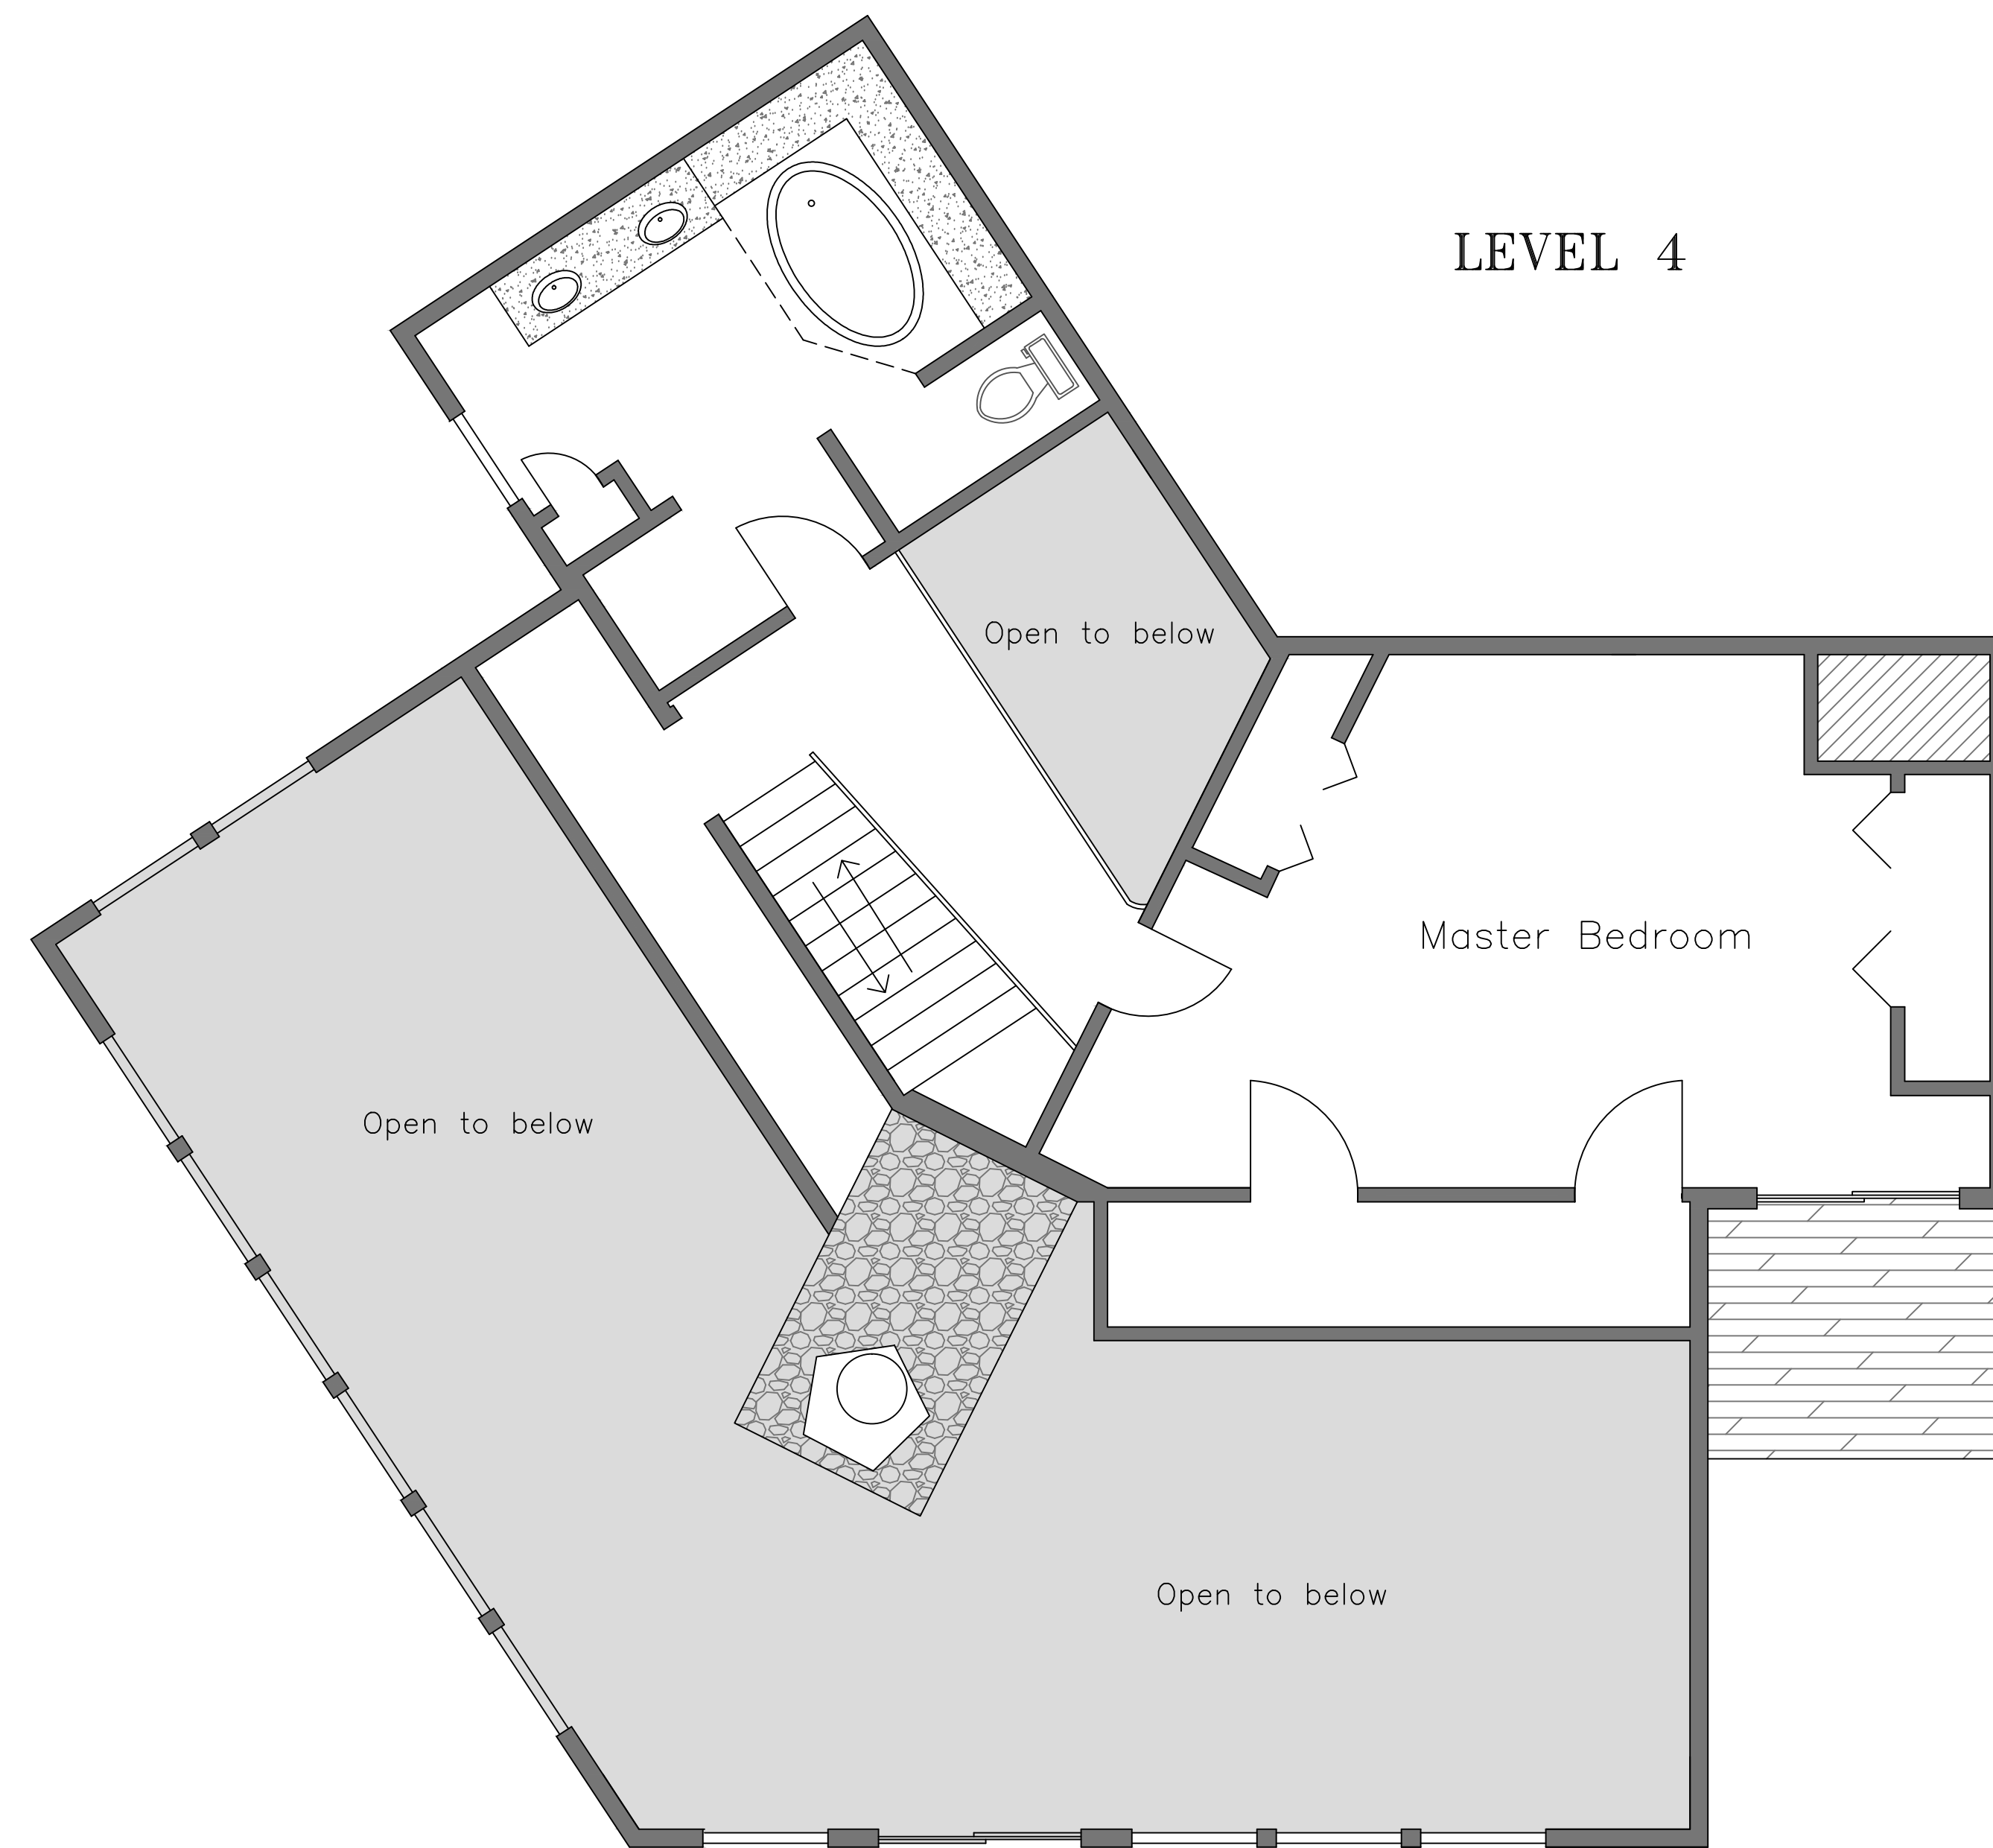

780
WEST LUPINE DRIVE
ASPEN, CO. 81611

LEVEL 4
857 sq. ft.

SCALE:

1/4" = 1'

DATE: 10/15/2015

PROJECT: AS BUILTS

SHEET:

A-2