



LEVEL 2

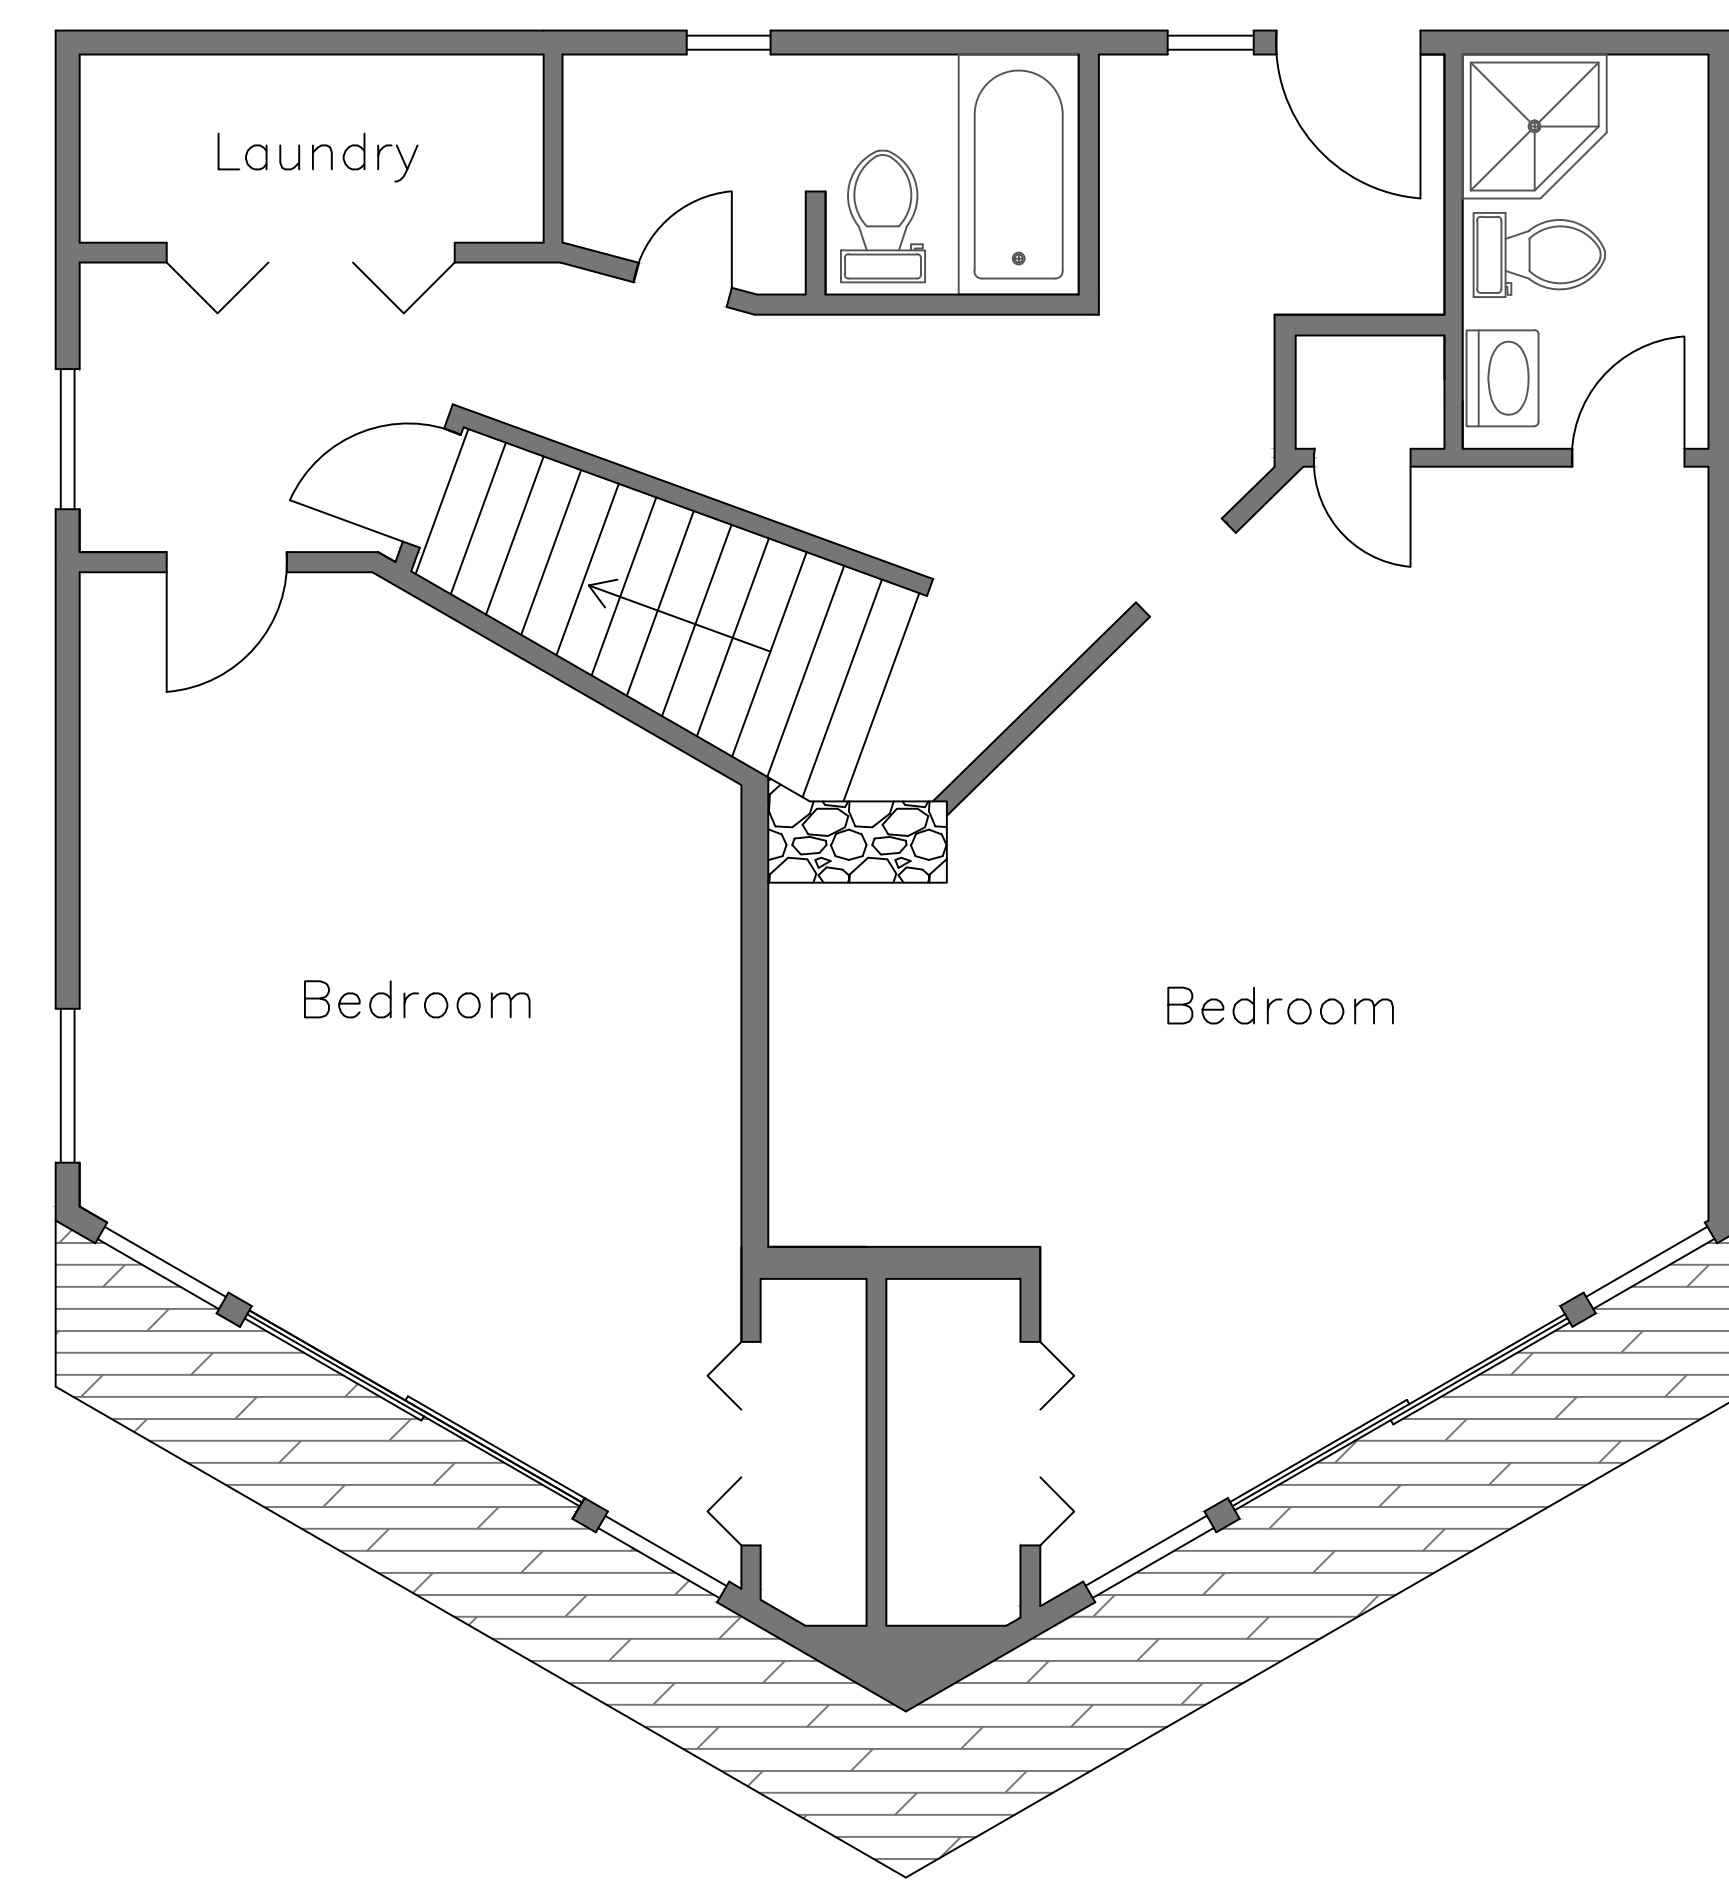

LEVEL 1

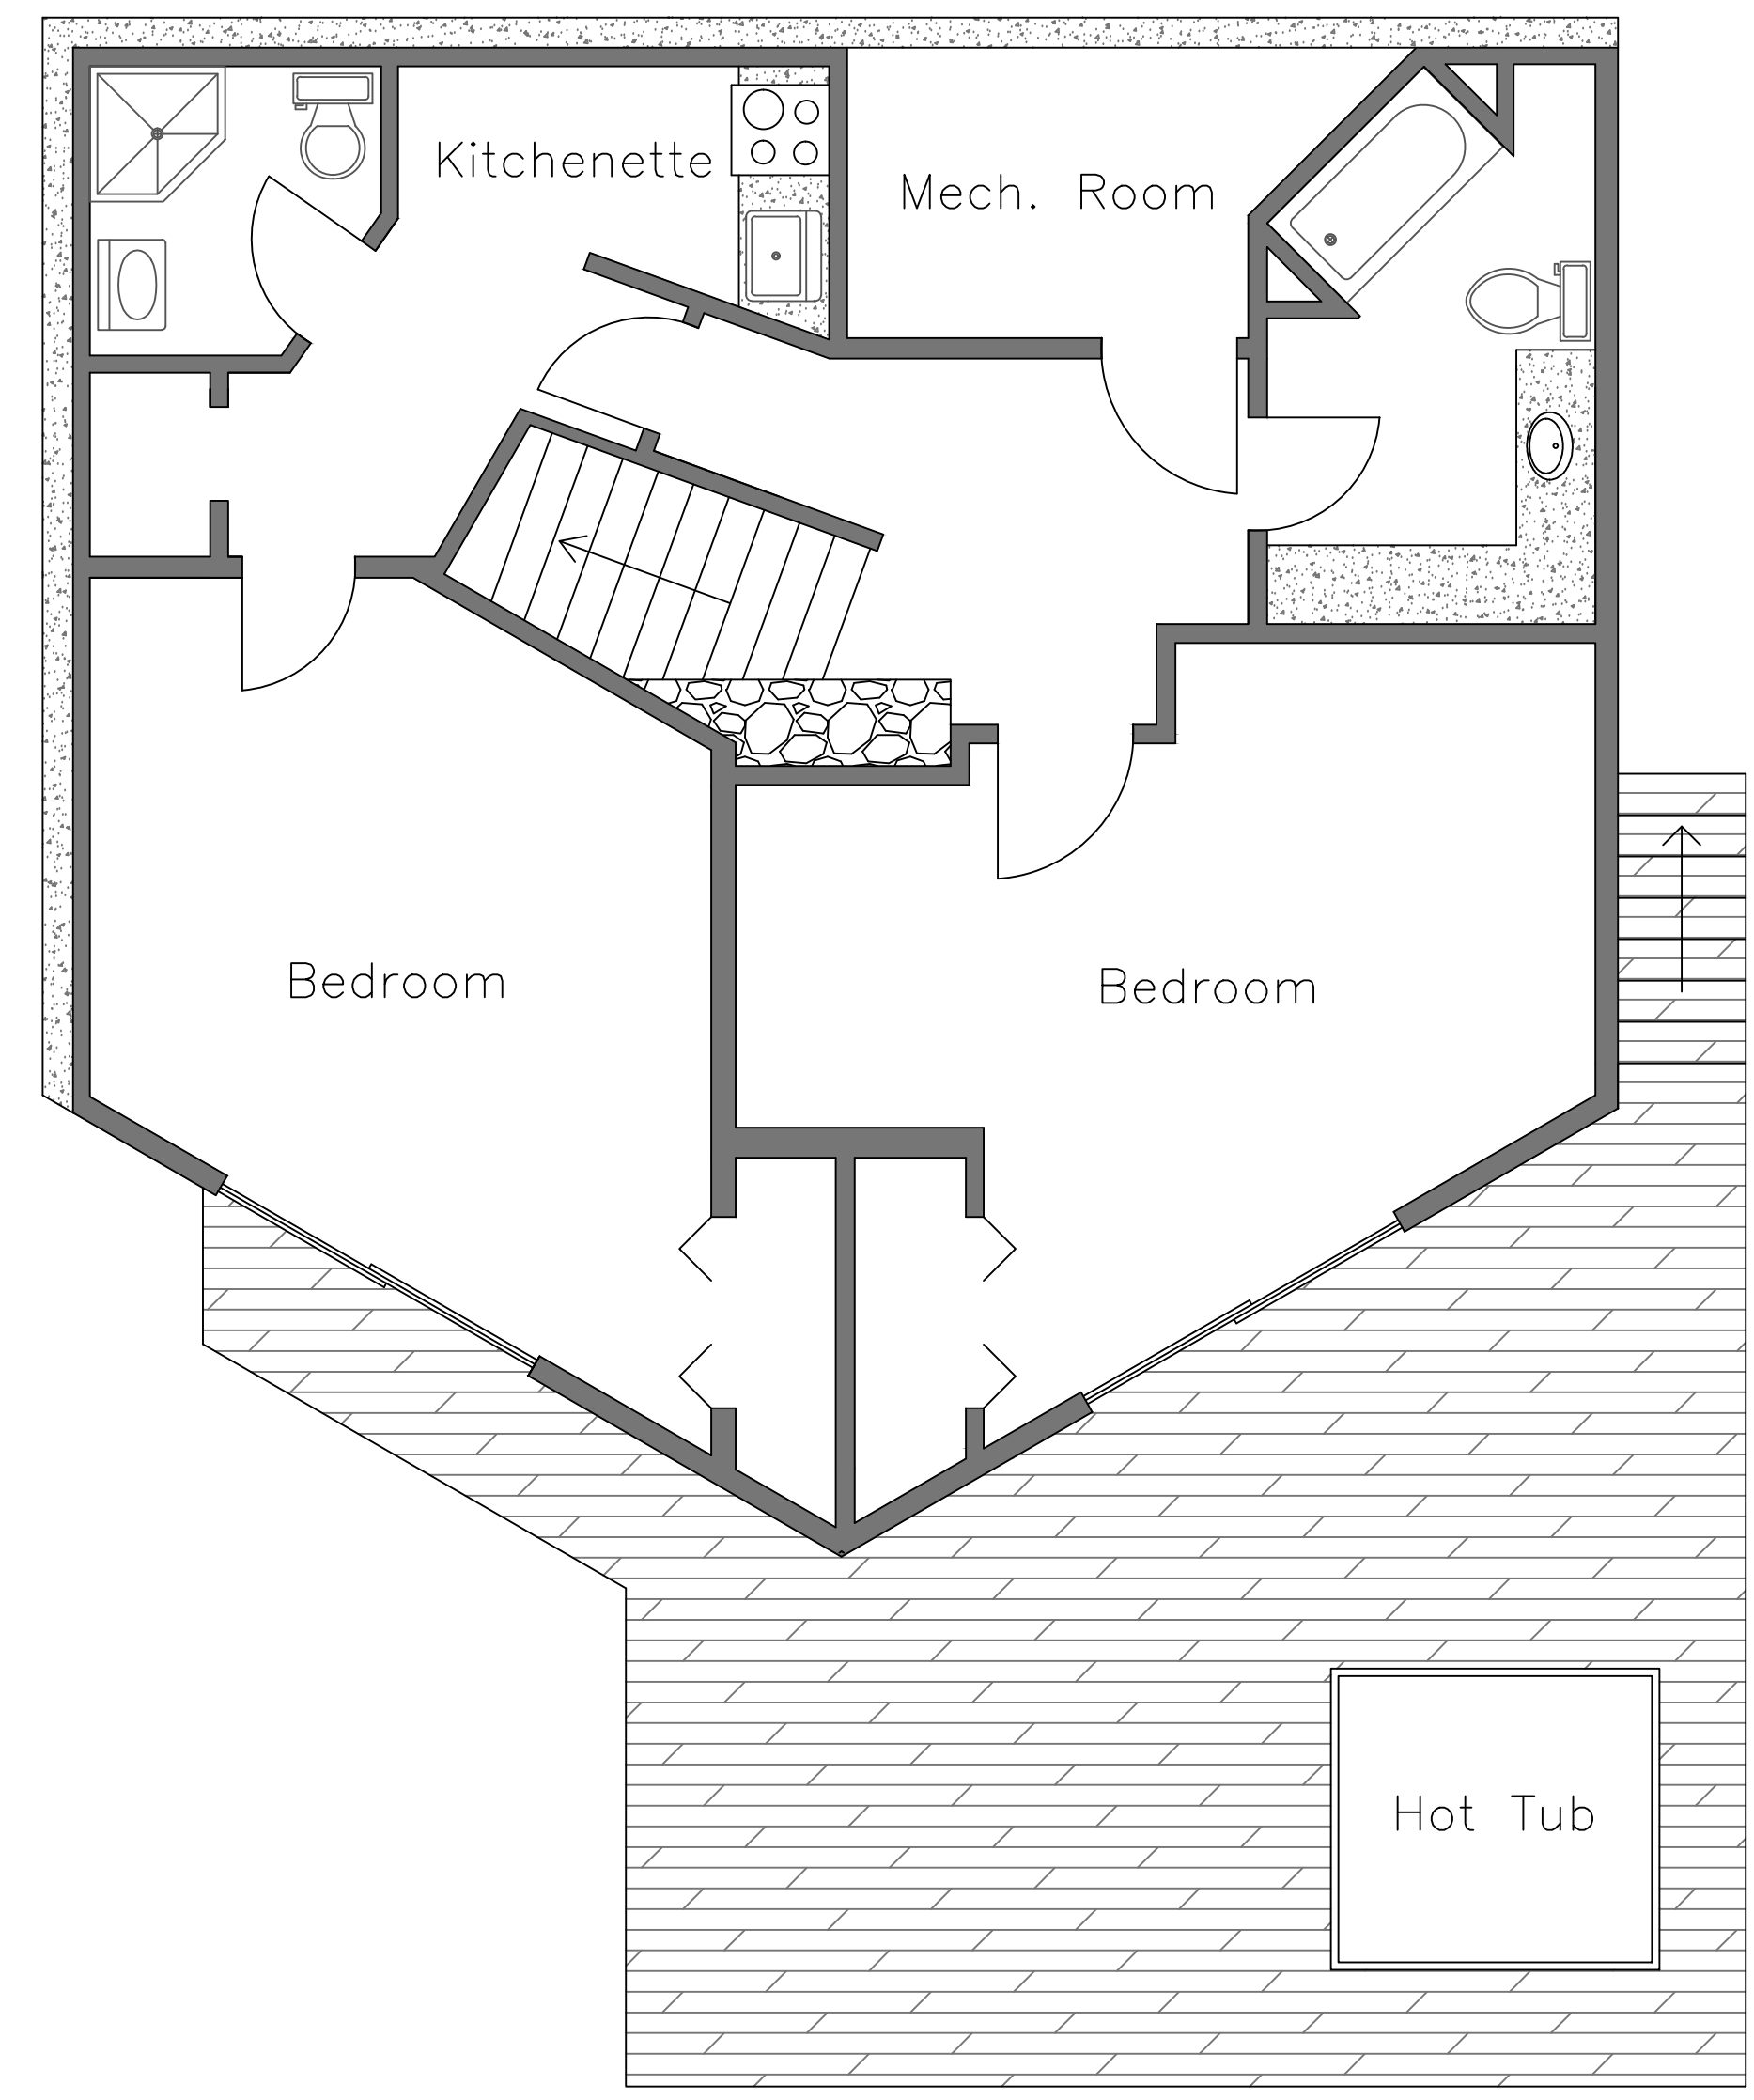

780
 WEST LUPINE DRIVE
 ASPEN, CO. 81611

LEVELS 1&2
 2,086 sq. ft.

SCALE:
 1/4" = 1'

DATE:
 10/15/2015

PROJECT:
 AS BUILTS

SHEET:
 A - 3